
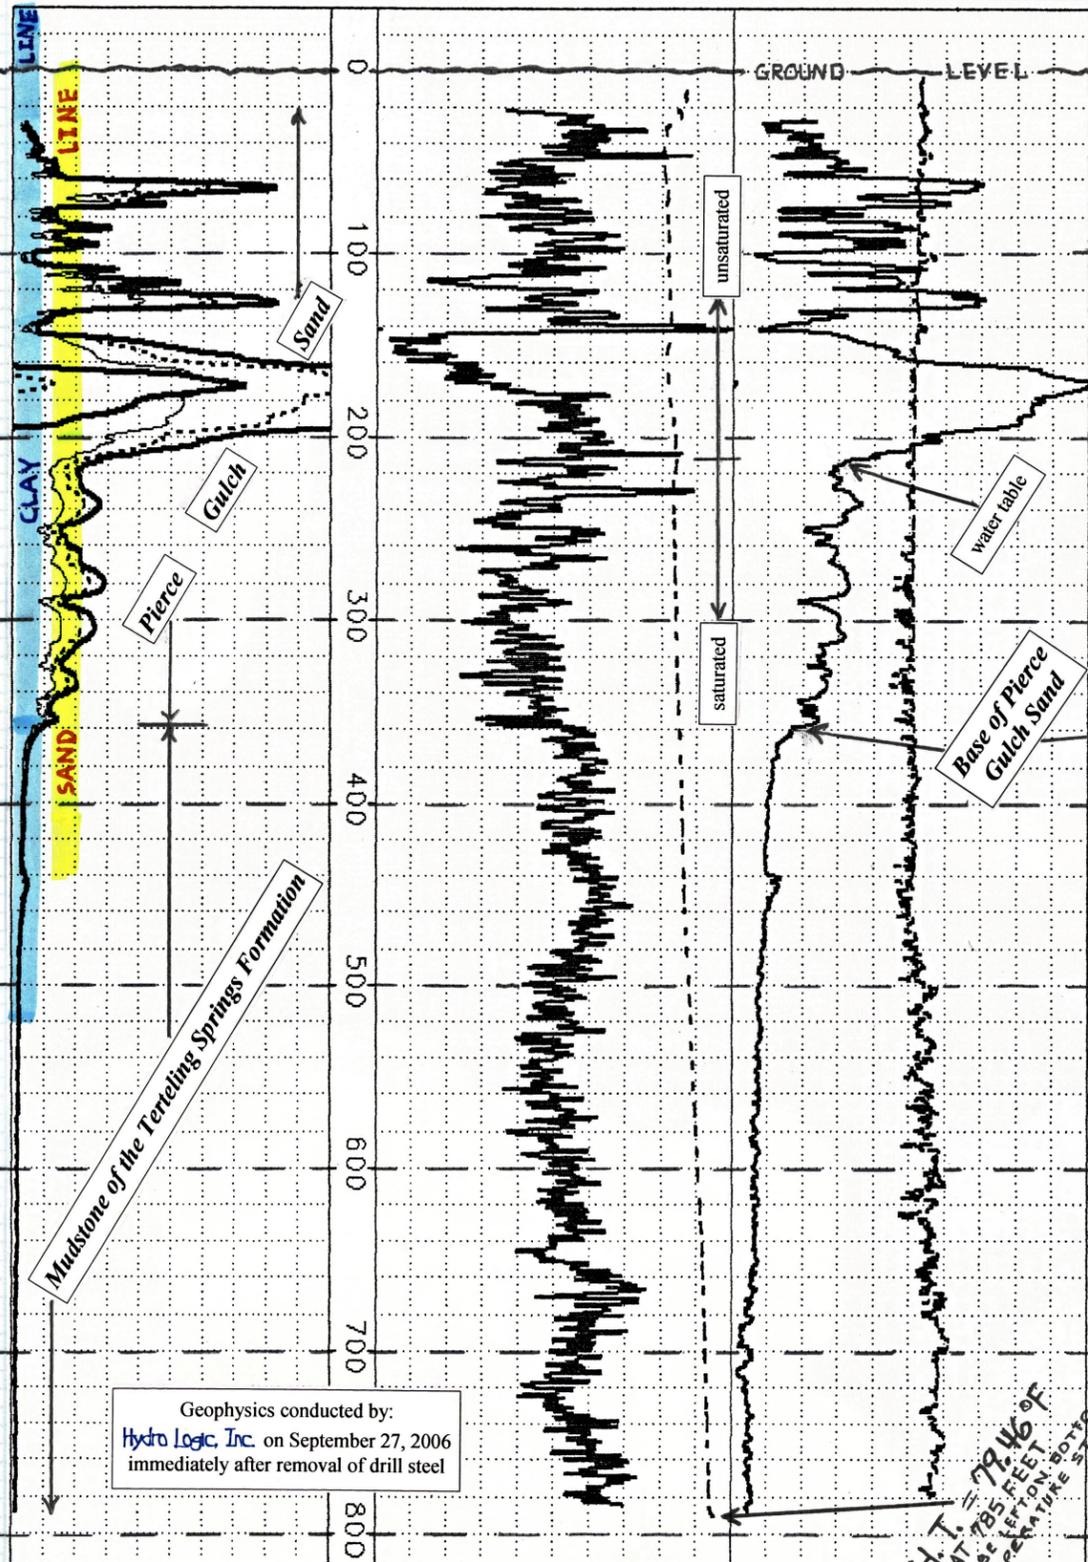


Geophysical Logs

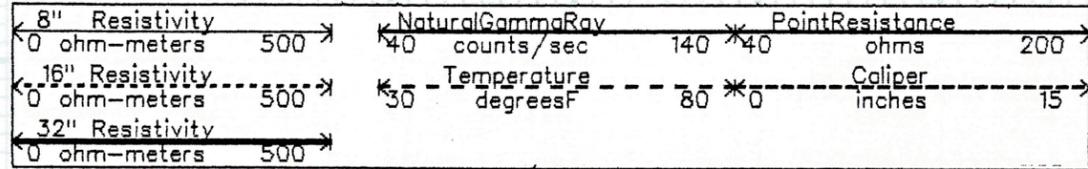


Geophysics conducted by:
 Hydro Logic, Inc. on September 27, 2006
 immediately after removal of drill steel

Lithology


Hydro Logic, Inc. lithologic log is interpreted and drawn from geophysical logs and drilled cuttings from the borehole.

Depth (feet below ground level)

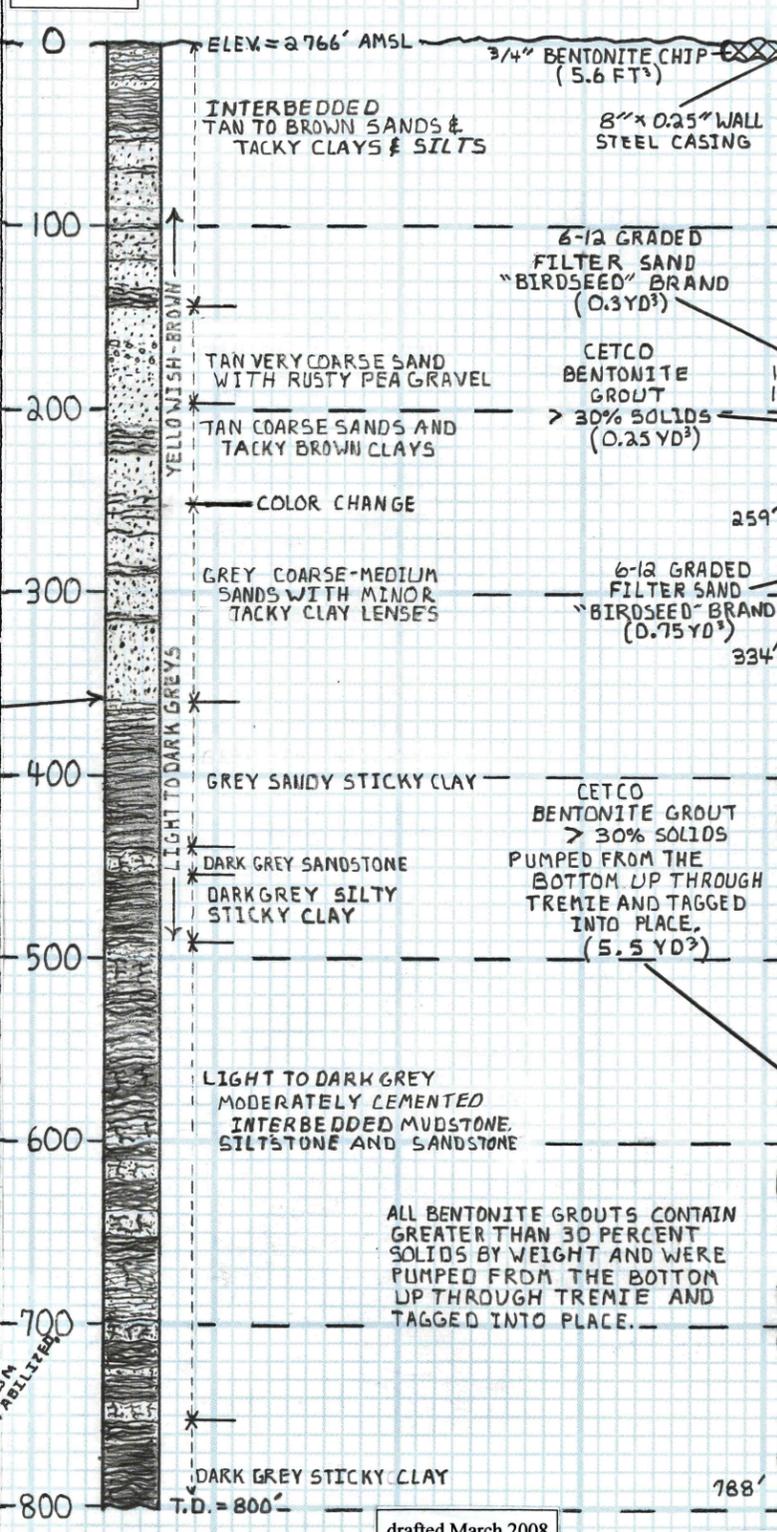


As-Built Well Construction

(horizontal scale 0.1"=1.0")
 (vertical scale 1"=100')

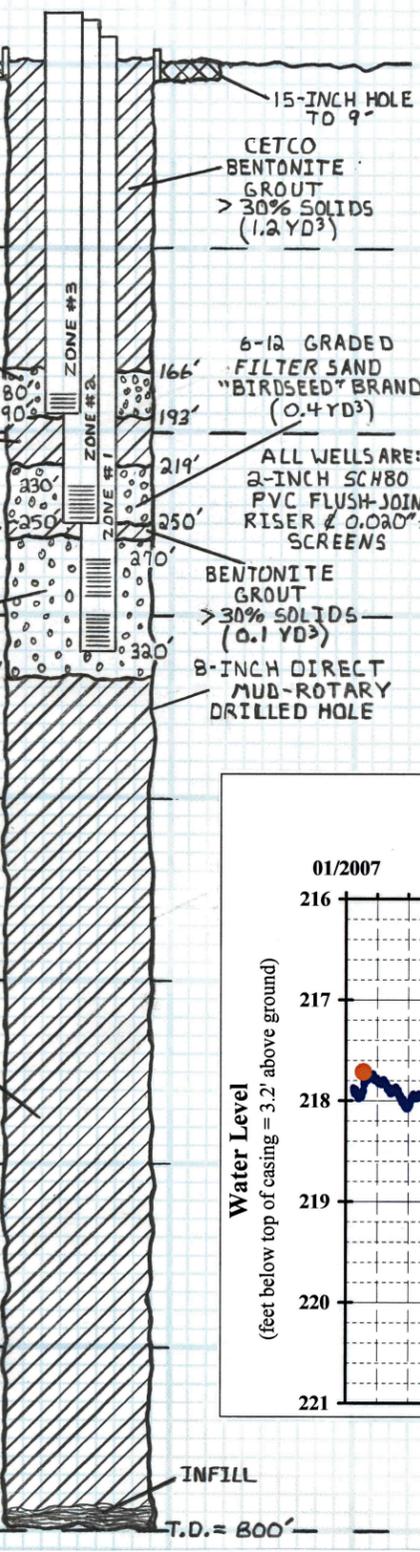

M3 Eagle - Test Well #2
 T. 5 N., R. 1 W., Section 23, NE 1/4, NW 1/4, NE 1/4
 Latitude 43° 45' 50.63" Longitude 116° 25' 6.58"
 Well completed October 2006

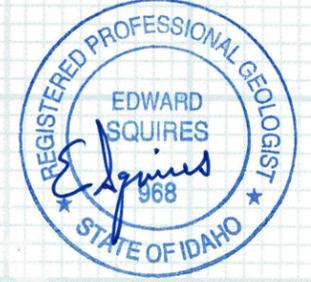

Water Levels


(feet below measure point = 3.0 feet above ground)

Date / Time (24-hr clock)	ZONE #1 (320 - 270 feet bgl)	ZONE #2 (250 - 230 feet bgl)	ZONE #3 (190 - 180 feet bgl)
10/10/06 13:05	216.87	-	-
11/07/06 12:00	217.23	217.36	-
1/18/07 14:27	217.19	217.37	-
4/30/07 15:25	216.97	215.76	-
6/01/07 12:00	216.17	216.75	-
7/24/07 12:30	-	217.11	-
7/31/07 13:00	217.58	217.91	-
8/30/07 12:20	217.60	217.93	-
9/19/07 16:30	215.93	216.26	-

Water levels recorded by Hydro Logic, Inc.

Water Level Monitoring - Zone #1

January 8, 2007 - March 31, 2008

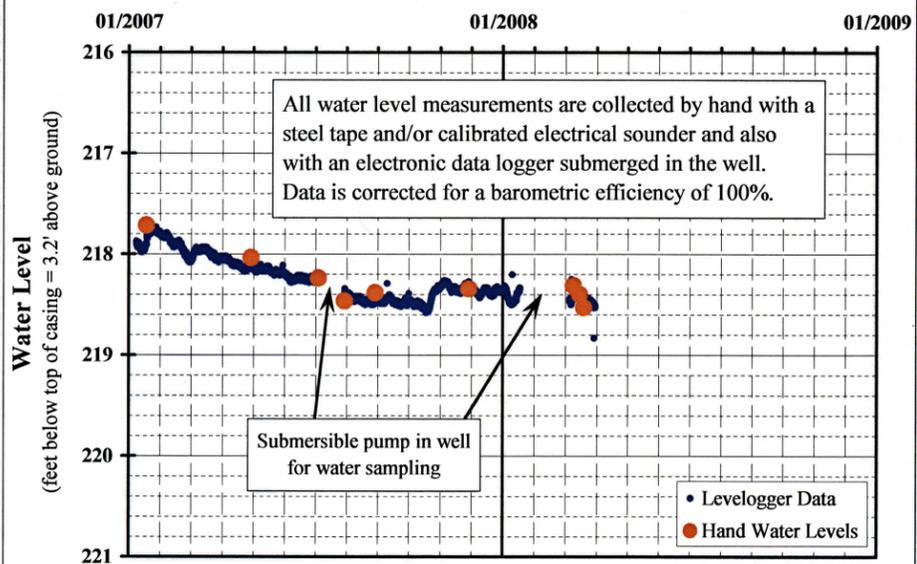

drafted March 2008
 by Loren Pearson

On site supervision, well design, pump test design, and water level monitoring by Hydro Logic, Inc., Boise, ID.
 Direct mud-rotary drilling and well construction by Treasure Valley Drilling and Pump, Inc., Weiser, ID
 Wells developed by McLeran Well Drilling, LLC, New Plymouth, ID.

©2008 Hydro Logic, Inc. This instrument is the property of Hydro Logic, Inc. Any reproduction, reuse, or modification of this instrument or its contents without the specific written permission of Hydro Logic, Inc. is strictly prohibited.